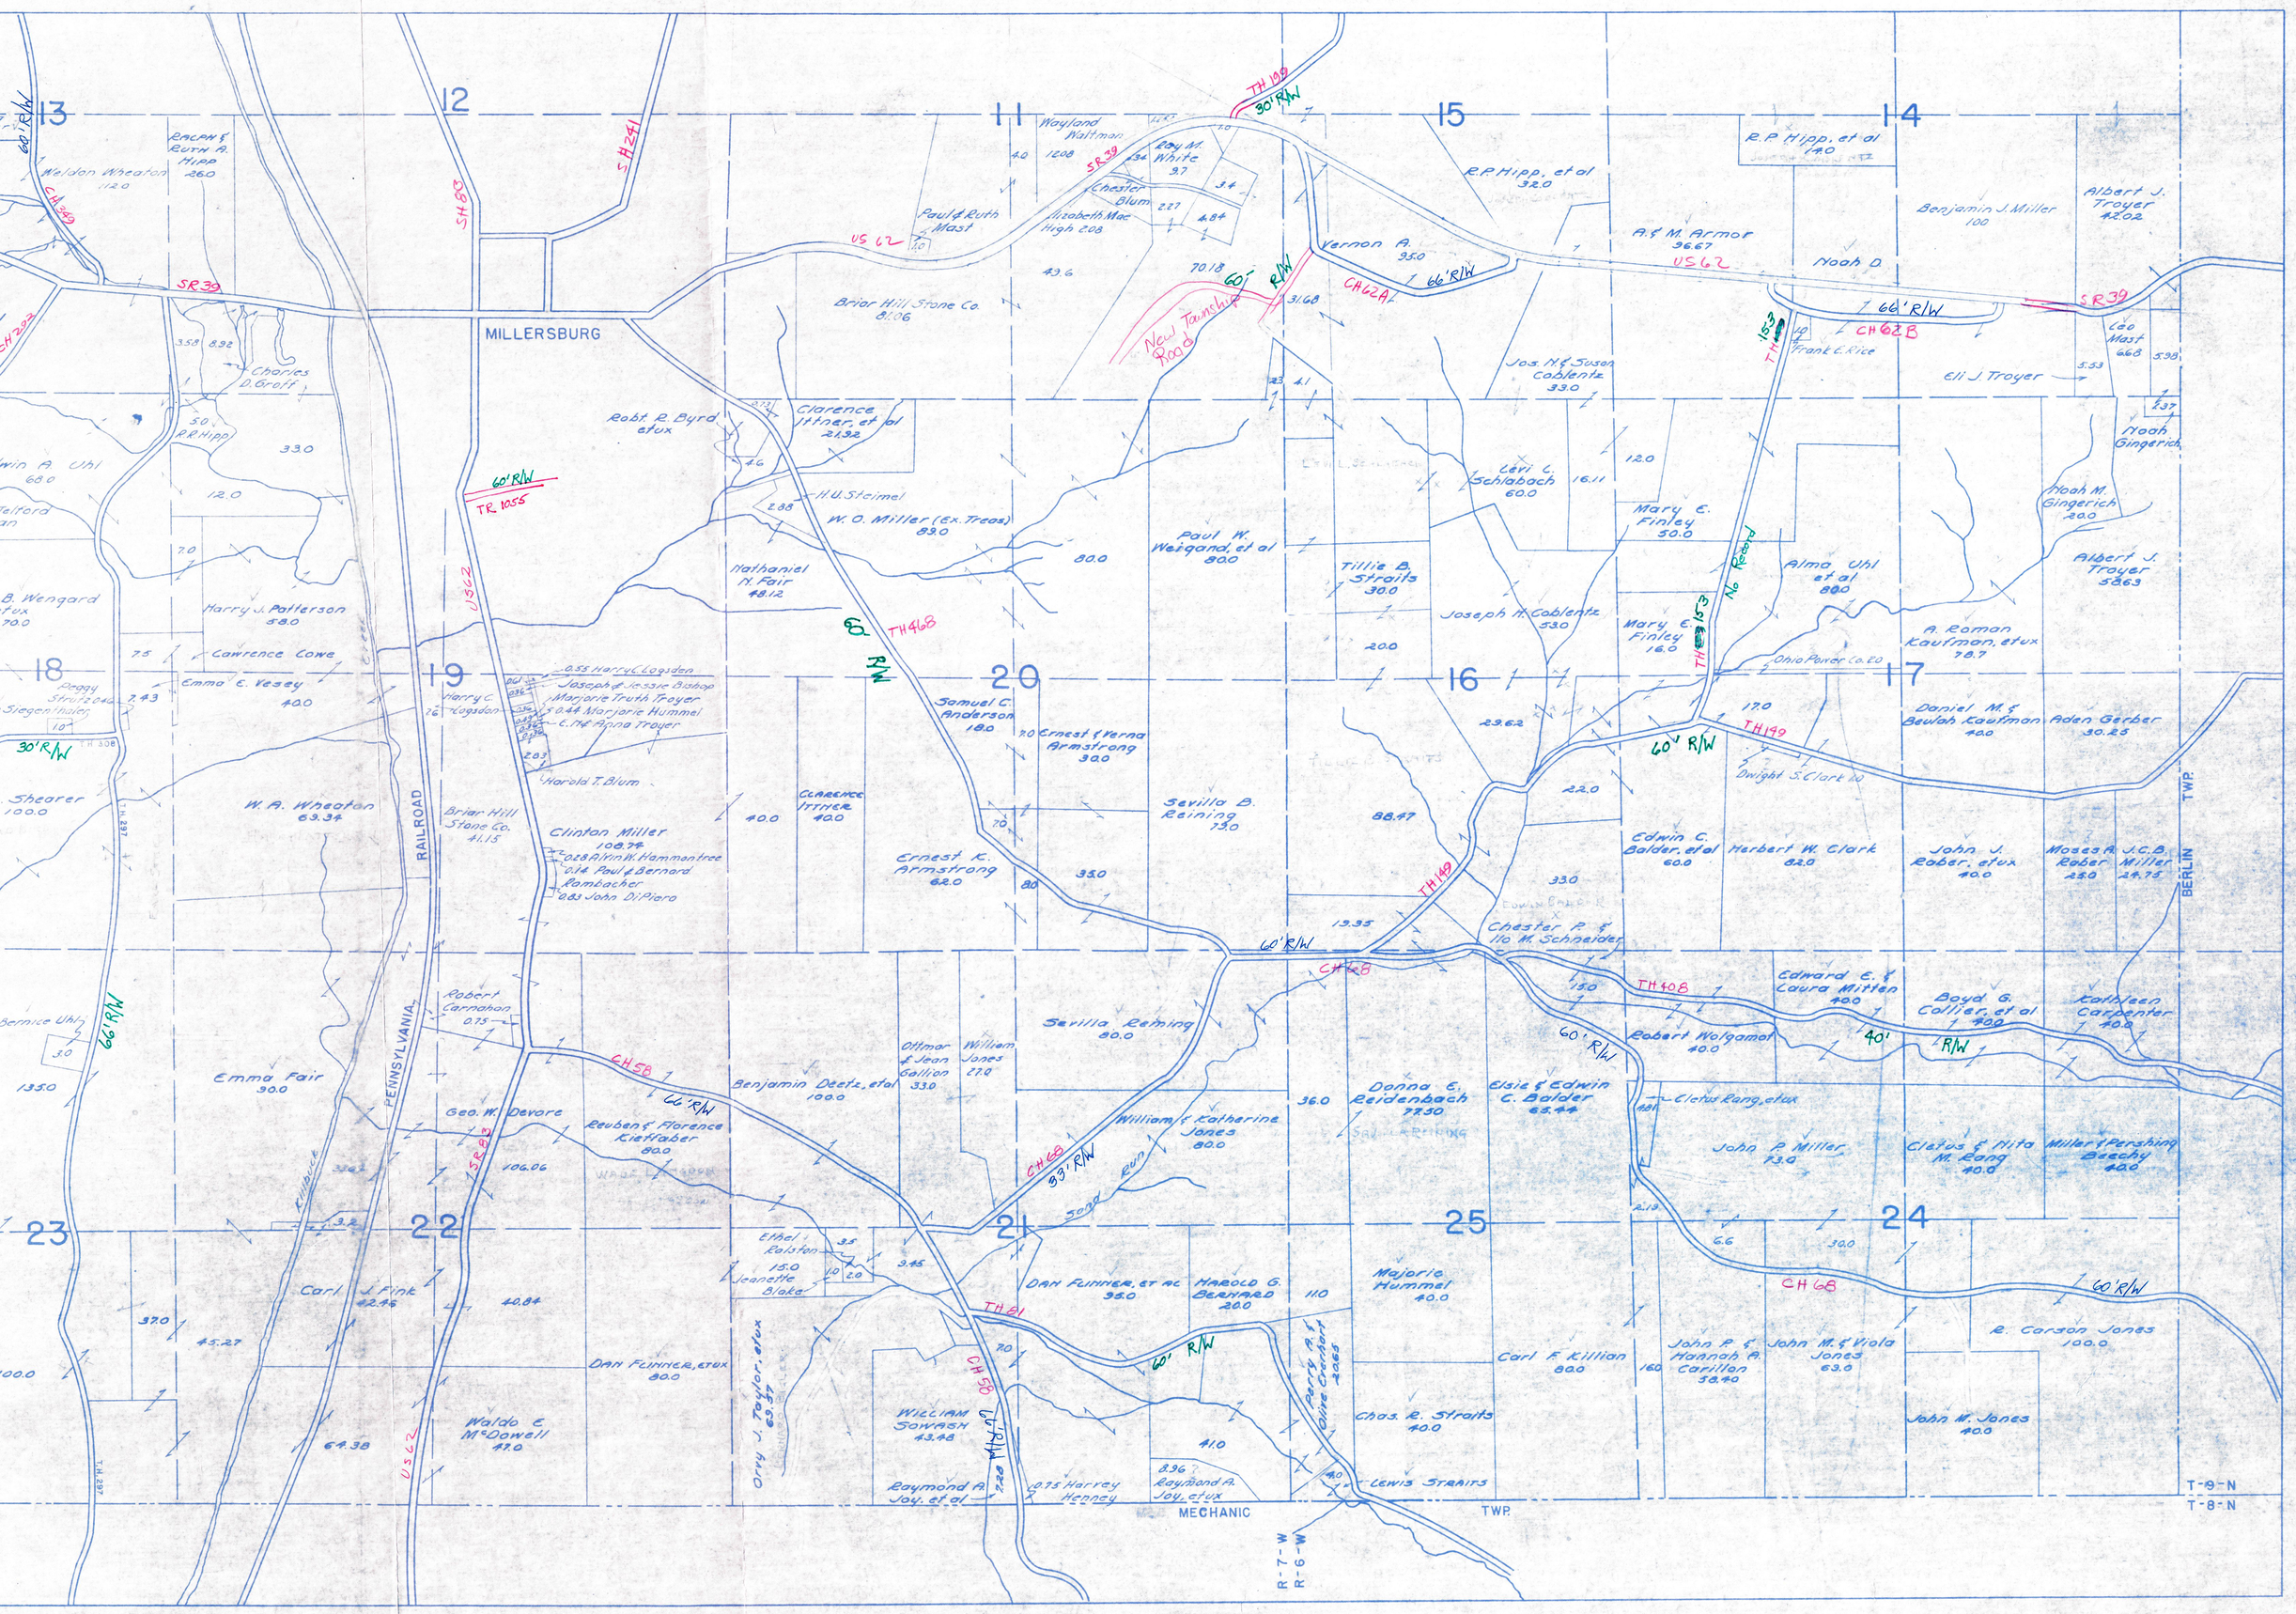

HOLMES COUNTY
HARDY TOWNSHIP
SOUTH PART

SCALE: 1" = 660'

Base map dated circa 1947

Date unknown for items marked in RED

KARL SNYDER - COUNTY ENGINEER
MYRON T. JONES - REG. PROF. ENG'R & SURV.